

For Sale




Eastwoods Business Center

4708 S Old Peachtree Rd, Building 900A
Norcross, GA 30071

Property Profile:

- Flex Property – 8,117 Total SF
- 2 Story office 5,339 sf /
2,778 sf warehouse
- 0.8 Acres
- Divisible
- Zoned M1
- Dock High – 2
- Parking Spaces – 20
- Ceiling Height – 22'

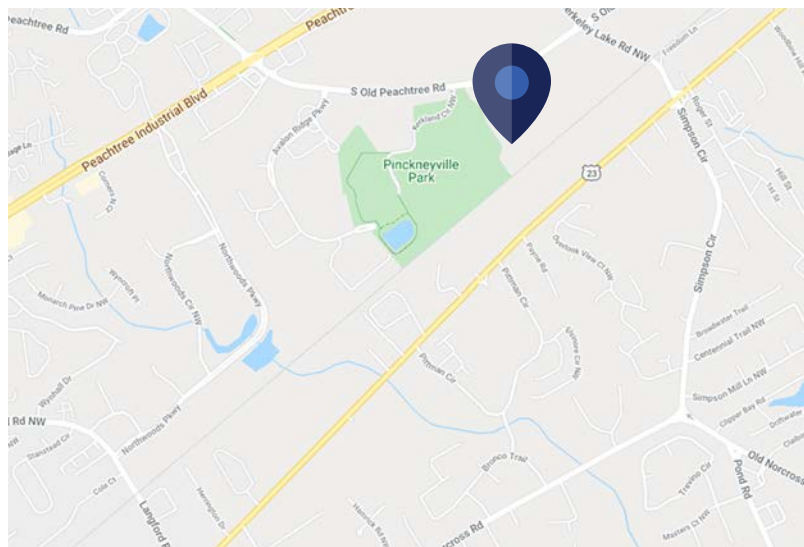

Contact:



Scott Clayton
404.446.1575
sclayton@cresa.com



Lucas Redd
404.446.1593
lredd@cresa.com



Eastwoods Business Center

4708 S Old Peachtree Rd


Contact:



Scott Clayton
404.446.1575
sclayton@cresa.com




Lucas Redd
404.446.1593
lredd@cresa.com

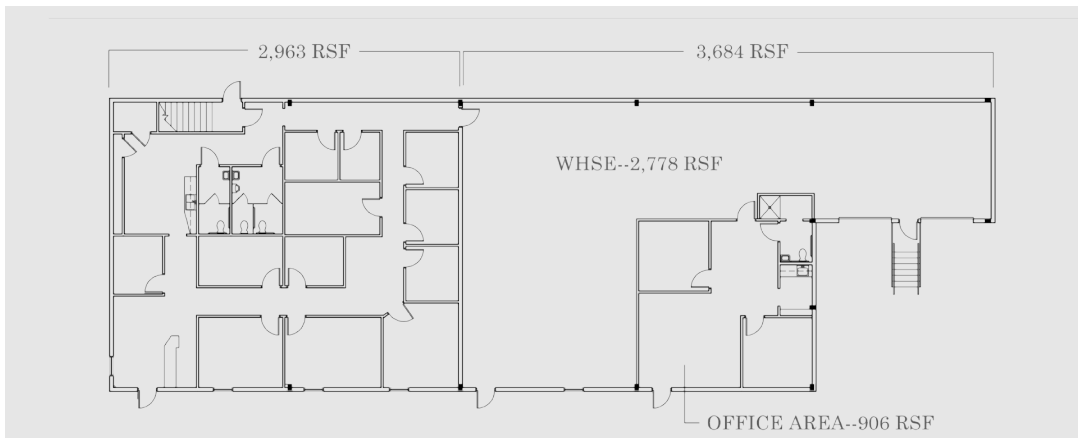

AS-BUILT PLAN FIRST FLOOR--6,647 RSF

SCALE: 1/8" = 1'-0"

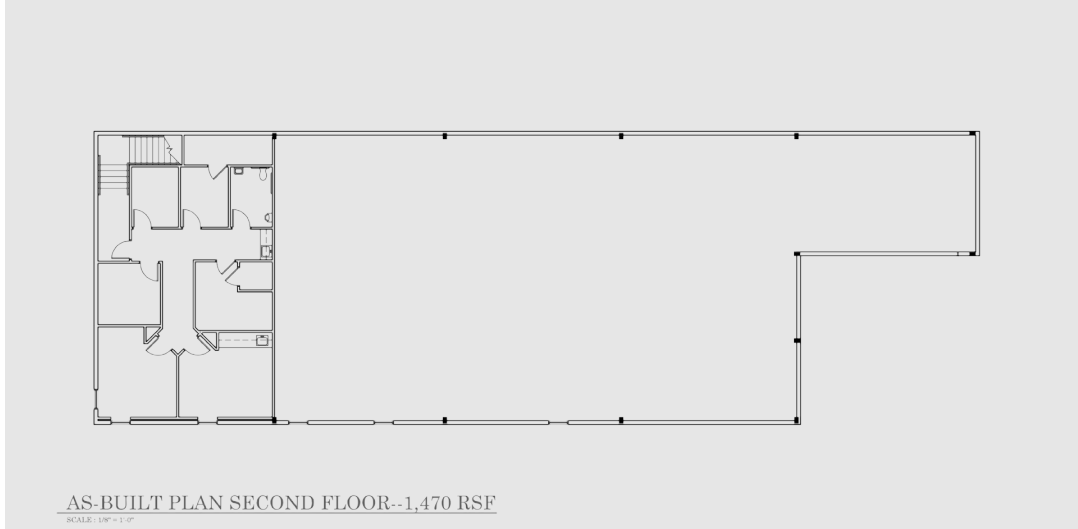

AS-BUILT PLAN SECOND FLOOR--1,470 RSF

SCALE: 1/8" = 1'-0"



Cresa © 2019. All rights reserved. The information contained in this document has been obtained from sources believed reliable. While Cresa does not doubt its accuracy, Cresa has not verified it and makes no guarantee, warranty, or representation about it. It is your responsibility to independently confirm its accuracy and completeness. Any projections, opinions, assumptions or estimates used are for example only and do not represent the current or future performance of the property. The value of this transaction to you depends on tax and other factors which should be evaluated by your tax, financial and legal advisors. You and your advisors should conduct a careful, independent investigation of the property to determine to your satisfaction the suitability of the property for your needs.